


**NOTES**

ALL DIMENSIONS IN mm  
 LIGHTING BARS S.W.L = 30KG/M  
 MAIN LIGHTING BARS HEIGHT = 3700mm  
 DOUBLE CYC TRACK S.W.L = 17.5KG/M  
 MAIN CURTAIN TRACK HEIGHT = 3100mm  
 STUDIO SCENE ACCESS = 2570MM(W) 3050mm(H)



| PRODUCTION TITLE   | DATE | REVISION DESCRIPTION | REV |
|--------------------|------|----------------------|-----|
| -                  | -    | -                    | -   |
| PRODUCTION COMPANY | -    | -                    | -   |
| PRODUCTION MANAGER | -    | -                    | -   |
| DIRECTOR           | -    | -                    | -   |
| LD                 | -    | -                    | -   |
| SET DESIGNER       | -    | -                    | -   |
| DATE               | -    | -                    | -   |

|             |              |                                |
|-------------|--------------|--------------------------------|
| PROJECT No. | 2550         | STUDIO D                       |
| FILE NAME   | 2550 04      | IMG STUDIOS                    |
|             | DO NOT SCALE | 5 LONGWALK ROAD, STOCKLEY PARK |
| DRAWN BY    | TDM          | UB11 1FE                       |
| APPROVED BY |              | +44 (0) 203314 5555            |
|             |              | DRAWING No 2550 04 01 01       |
|             |              | DATE 2nd APRIL 2016            |
|             |              | SCALE 1:30 @ A1                |
|             |              | REVISION D                     |
|             |              | ISSUE AS BUILT                 |



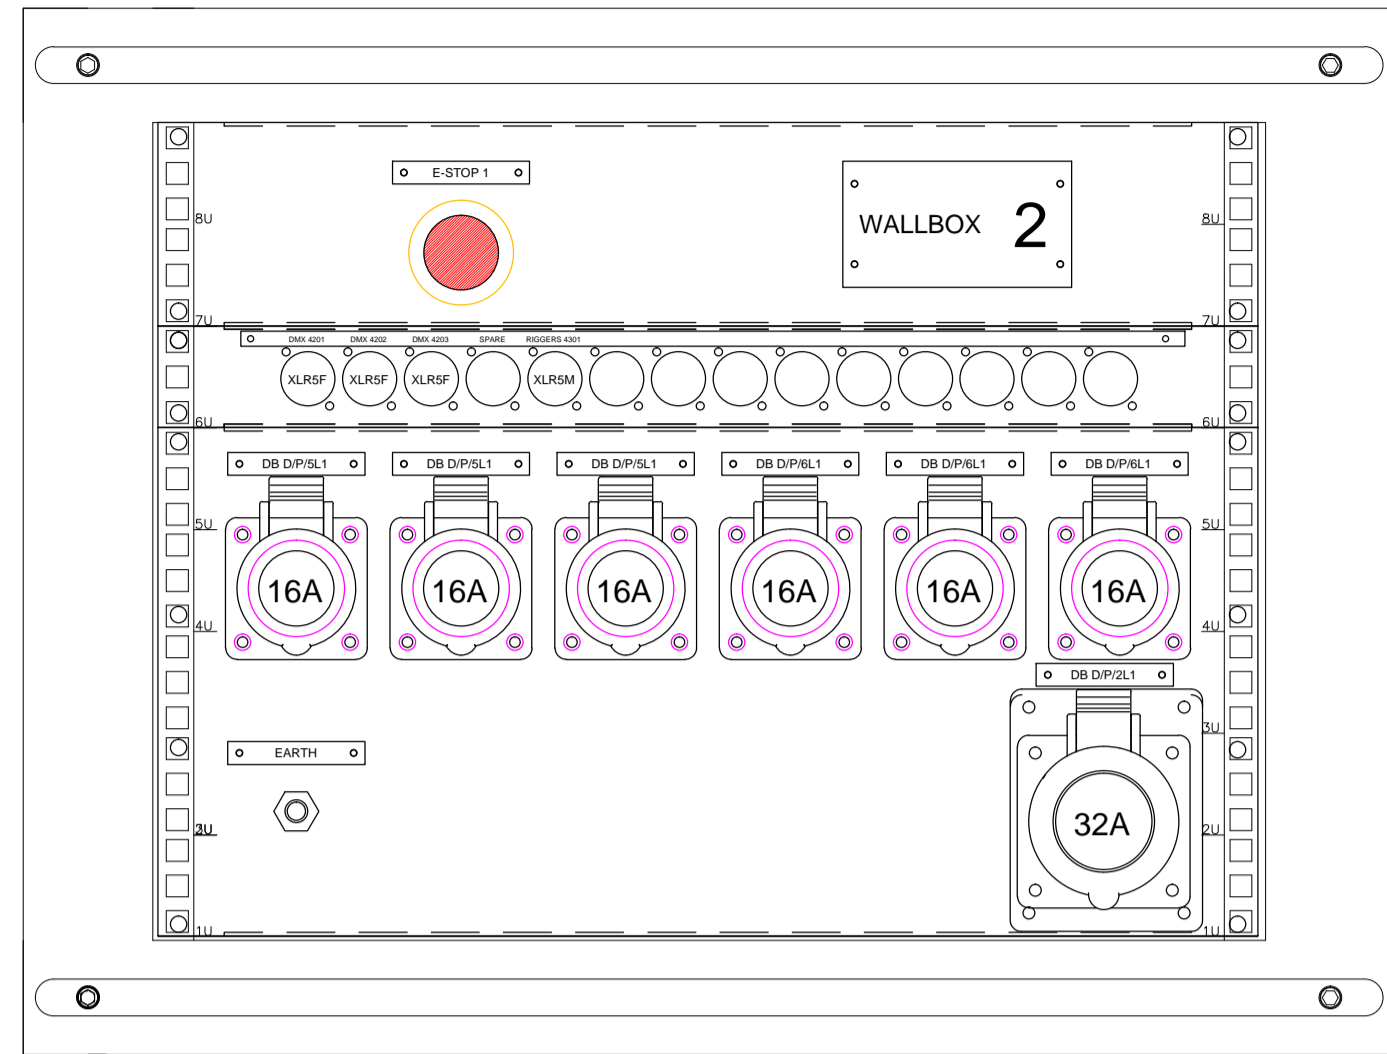

32 AMP on D1,D2,D5,D4

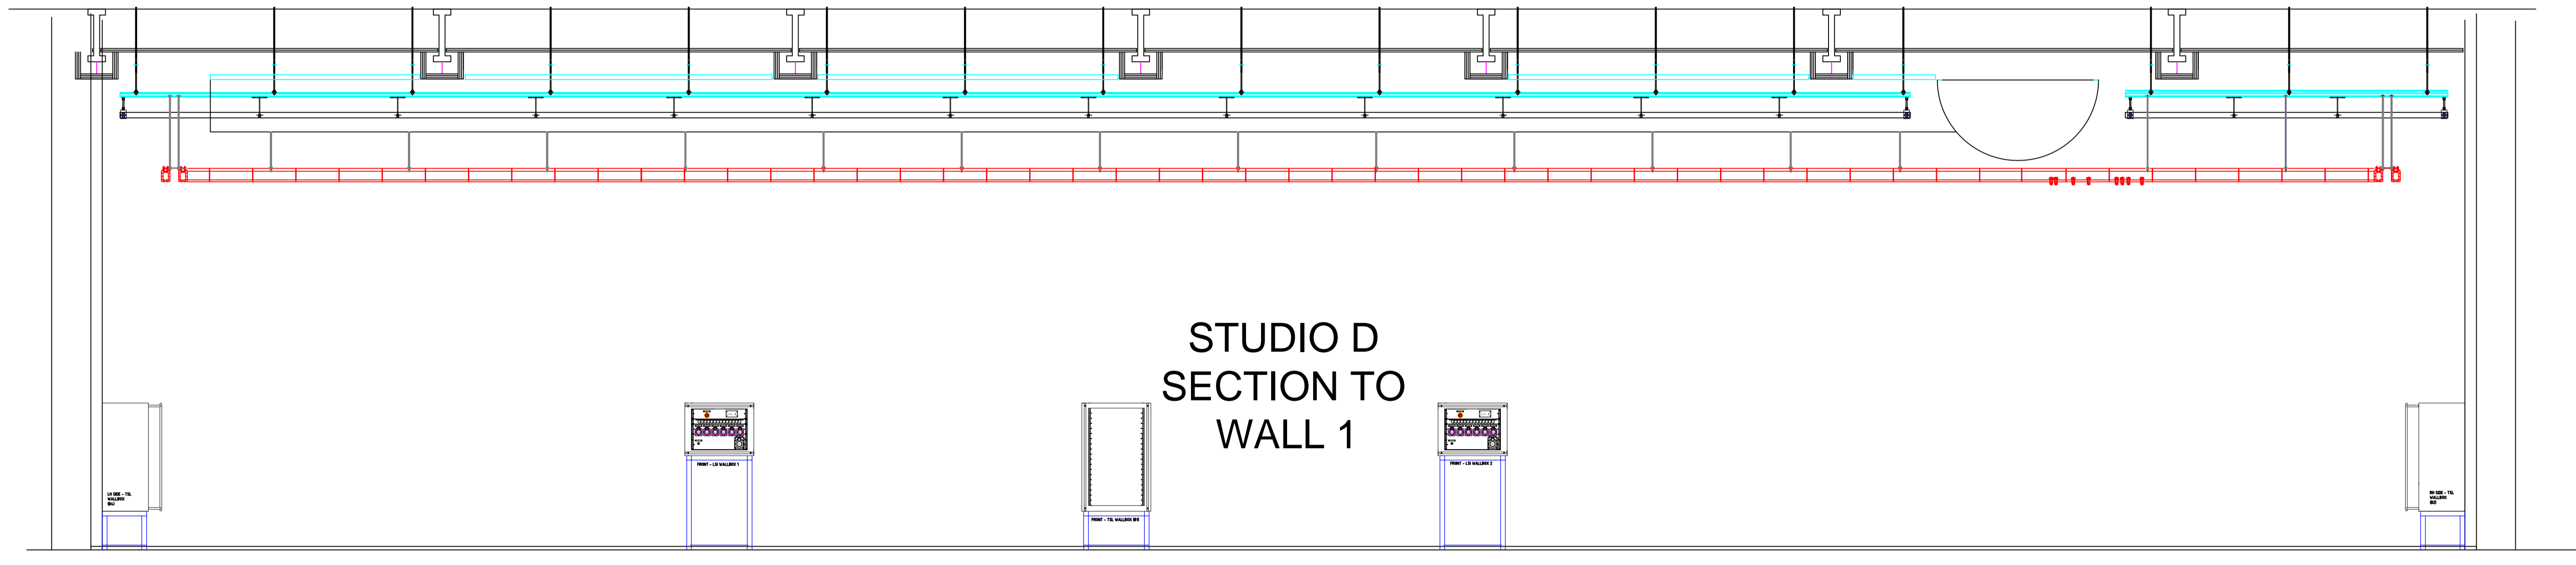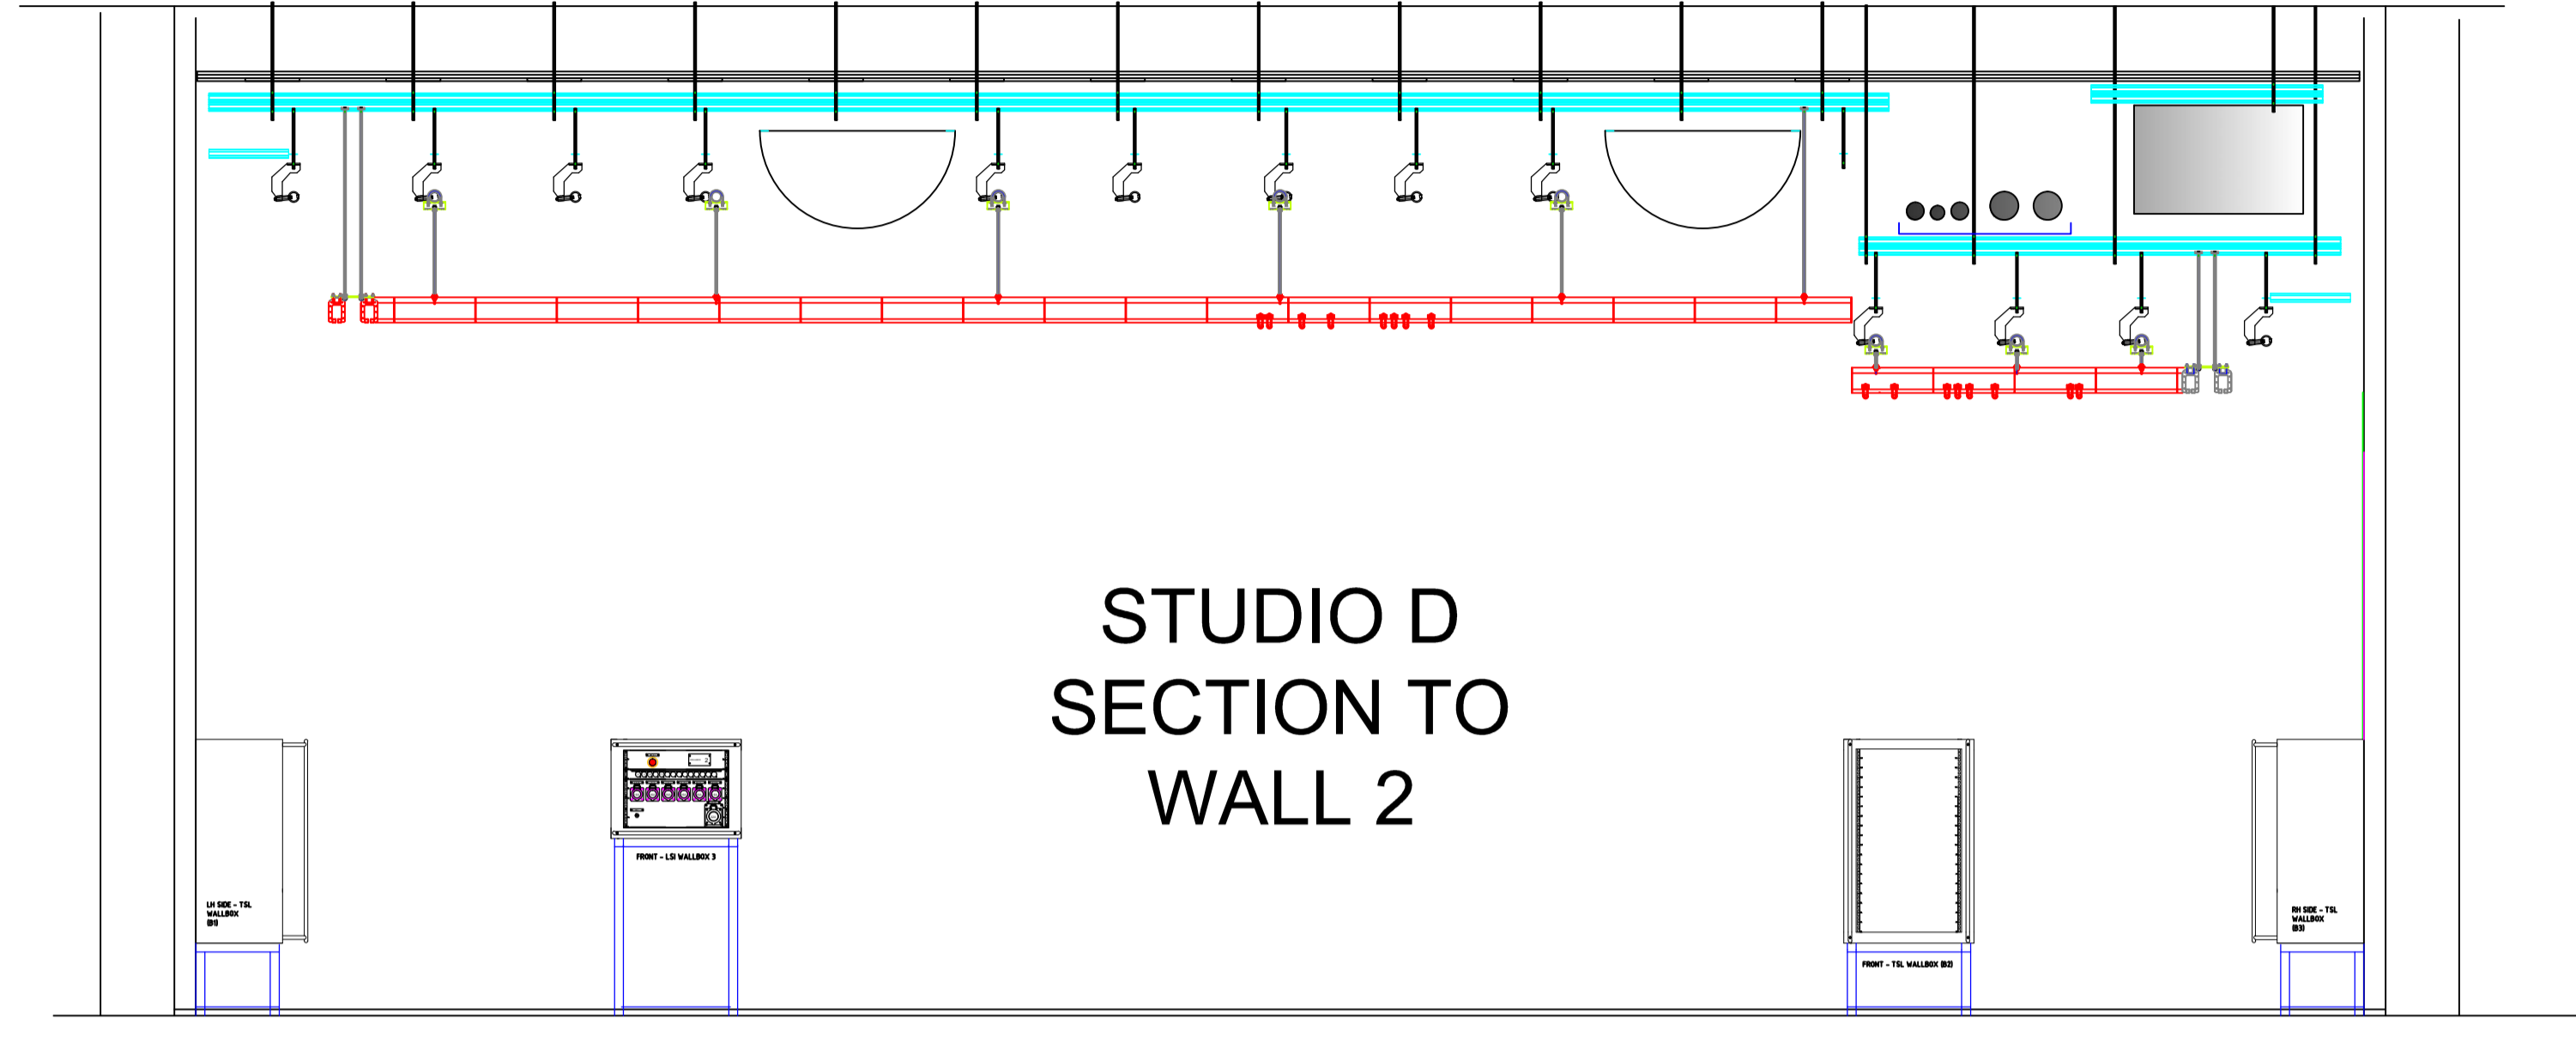

**NOTES**

ALL DIMENSIONS IN mm  
 LIGHTING BARS S.W.L = 30KG/M  
 MAIN LIGHTING BARS HEIGHT = 3700mm  
 DOUBLE CYC TRACK S.W.L = 17.5KG/M  
 MAIN CURTAIN TRACK HEIGHT = 3100mm  
 STUDIO SCENE ACCESS = 2570MM(W) 3050mm(H)

| PRODUCTION TITLE   | DATE | REVISION DESCRIPTION | REV |
|--------------------|------|----------------------|-----|
| -                  | -    | -                    | -   |
| PRODUCTION COMPANY | -    | -                    | -   |
| PRODUCTION MANAGER | -    | -                    | -   |
| DIRECTOR           | -    | -                    | -   |
| LD                 | -    | -                    | -   |
| SET DESIGNER       | -    | -                    | -   |
| DATE               | -    | -                    | -   |

|              |         |  |                   |
|--------------|---------|--|-------------------|
| PROJECT No.  | 2550    | STUDIO D<br>IMG STUDIOS<br>5 LONGWALK ROAD, STOCKLEY PARK<br>UB11 1FE<br>+44 (0) 203314 5555 | REVISION <b>D</b> |
| FILE NAME    | 2550 04 |  |                   |
| DO NOT SCALE |         | DRAWING No. 2550 04 01 01  | ISSUE AS BUILT    |
| DRAWN BY     | TDM     | DATE 2nd APRIL 2016  | SCALE 1:30 @ A1   |
| APPROVED BY  |         |  |                   |